This document and the design it covers are the property of PARSONS. They are loaned only with the borrower's expressed written agreement that they will not be reproduced, copied, loaned, exhibited, or used in any other way, except by written consent from PARSONS to the borrower.

DATE: 08/14/98 TIME: 19:00:23
DESIGN FILE: I:\ligo\site2\mu\lap112.d3z

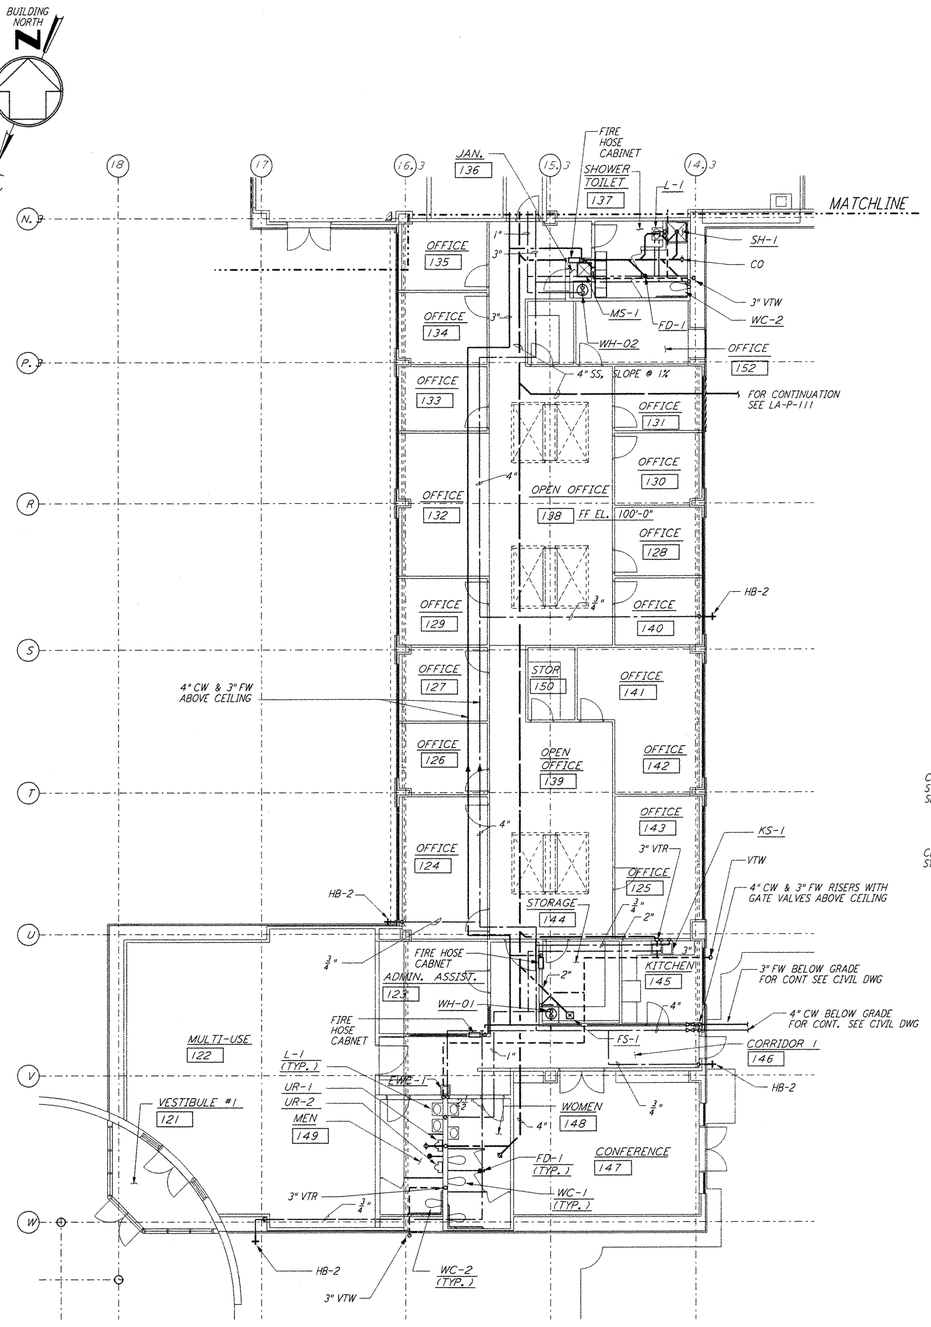

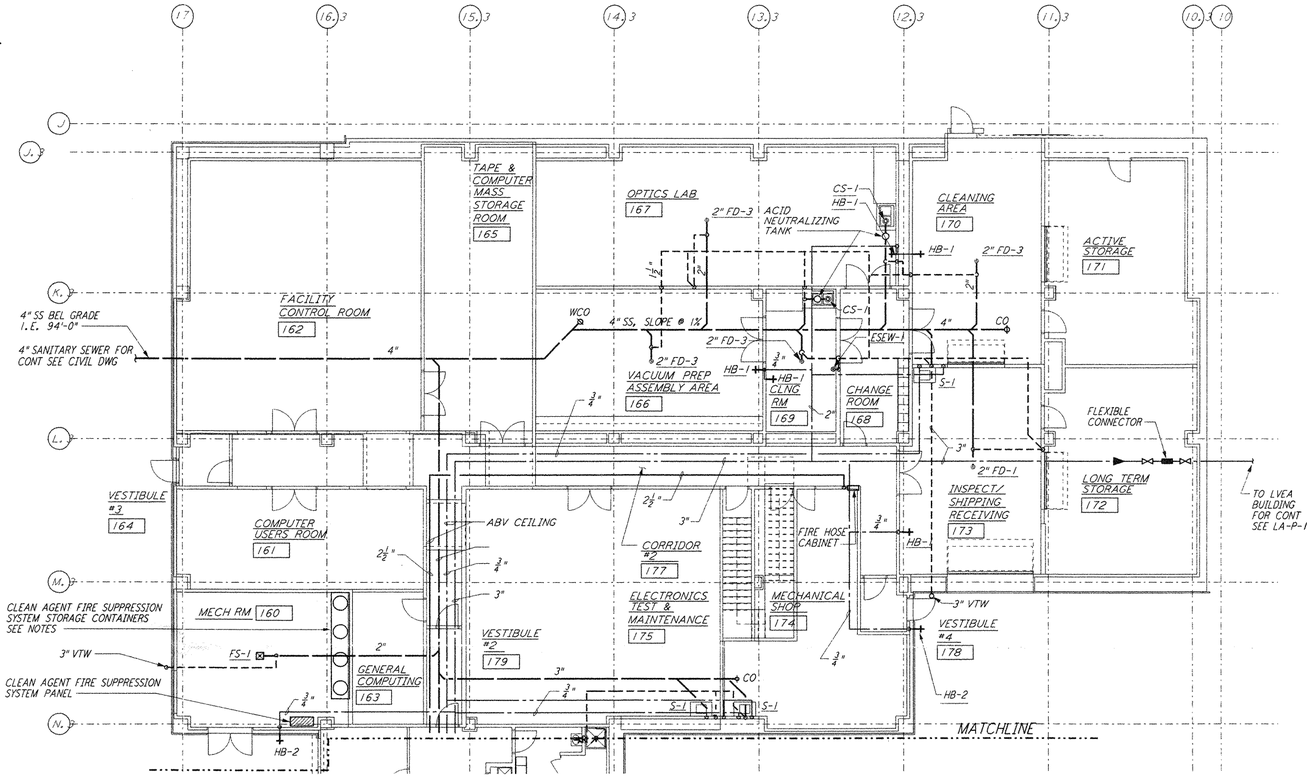

NOTES:

1. A CLEAN AGENT FIRE SUPPRESSION SYSTEM SHALL BE PROVIDED ABOVE AND WITHIN THE DEPRESSED FLOOR SPACE, FOR THE FOLLOWING ROOMS:
   - A. FACILITY CONTROL ROOM [162]
   - B. TAPE & COMPUTER MASS STORAGE ROOM [165]
   - C. COMPUTER USERS ROOM [161]
   - D. GENERAL COMPUTING [163]
2. REFER TO THE PERFORMANCE TYPE SPECIFICATIONS FOR REQUIREMENTS AND DESIGN CRITERIA.

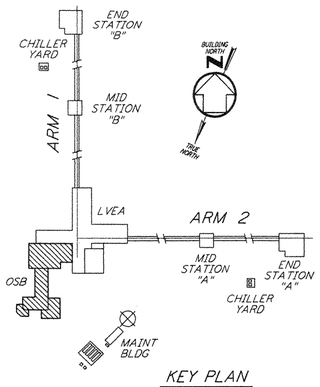

KEY PLAN

0 8 16 24 32FT
1/8" = 1'-0"

LIGO-D961049-02-O

REFERENCES

DRAWING NO.	DESCRIPTION

REVISIONS

NO.	DATE	BY	CHKD	ENGR	PROJ	DESCRIPTION
2	8-7-98	DJB	MW	MM	MW	ISSUED FOR AS-BUILT
1	3-20-97	WNK	AA	AA	TDM	REVISED PLUMBING PIPING LAYOUT

ISSUED FOR CONSTRUCTION

DRAWN	DG	11-15-96
CHECKED	ME	10-25-96
ENGINEER	AA	10-25-96
PROJ	TDM	11-15-96

AS-BUILT DRAWINGS

PARSONS
100 WEST WALNUT STREET
PASADENA, CALIFORNIA

LIGO
CALIFORNIA INSTITUTE OF TECHNOLOGY
MASSACHUSETTS INSTITUTE OF TECHNOLOGY

LASER INTERFEROMETER
GRAVITATIONAL-WAVE OBSERVATORY
SITE NO. 2 - LIVINGSTON, LOUISIANA

TITLE: PLUMBING CORNER STATION OSB FLOOR PLAN

SCALE	CONTRACT NUMBER	PROJECT NUMBER
AS NOTED	PP150969	8094

SHEET NUMBER: LA-P-112
REVISIONS: 2

LIGOLAF3.BDR

Fri Aug 14 18:59:44 1998 C:\PLOT\OUE\S3-V3682.DGF 52085 K1-V3682-mu112.prf