
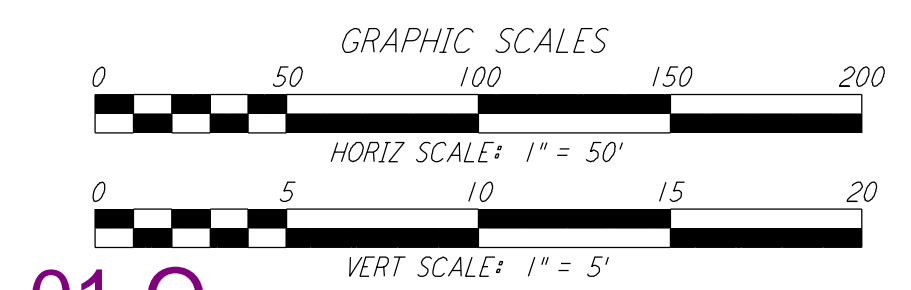
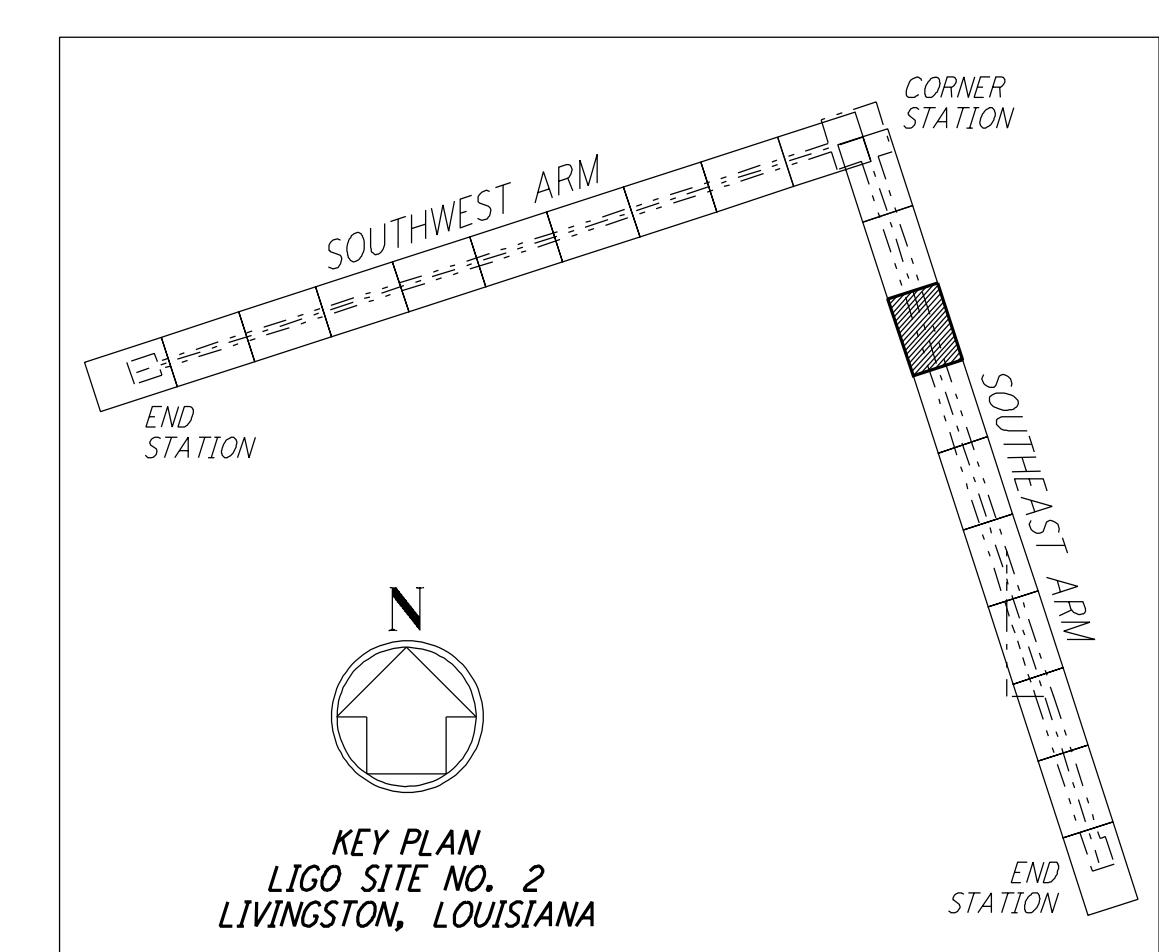
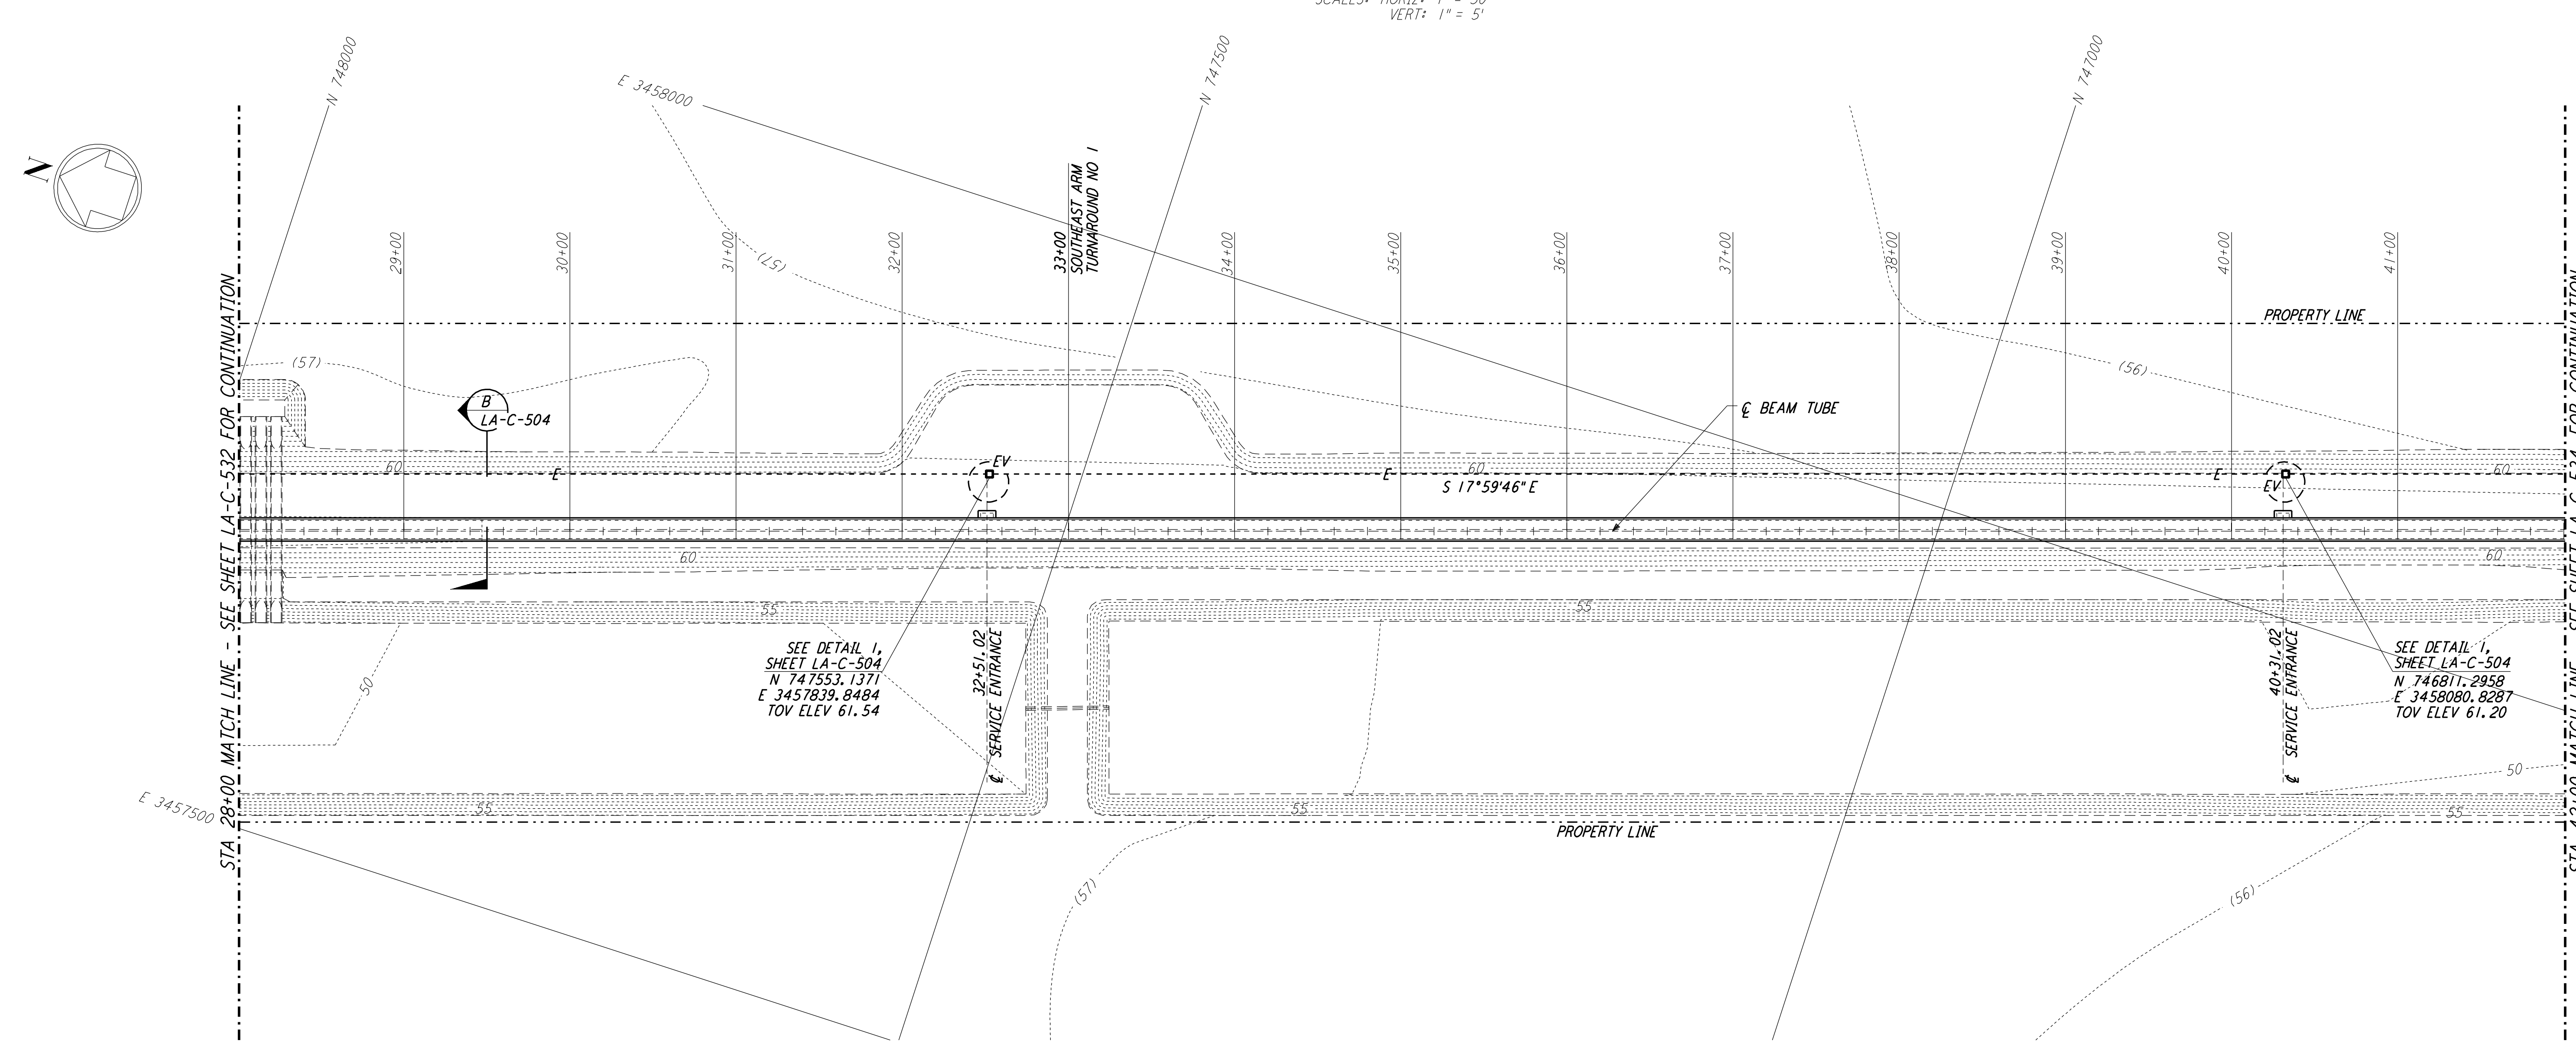


- NOTES:**
- SEE SHEET LA-C-502 FOR GENERAL NOTES, LEGEND AND ABBREVIATIONS.
 - SEE SHEET LA-C-504 FOR TYPICAL SECTIONS AND DETAILS.

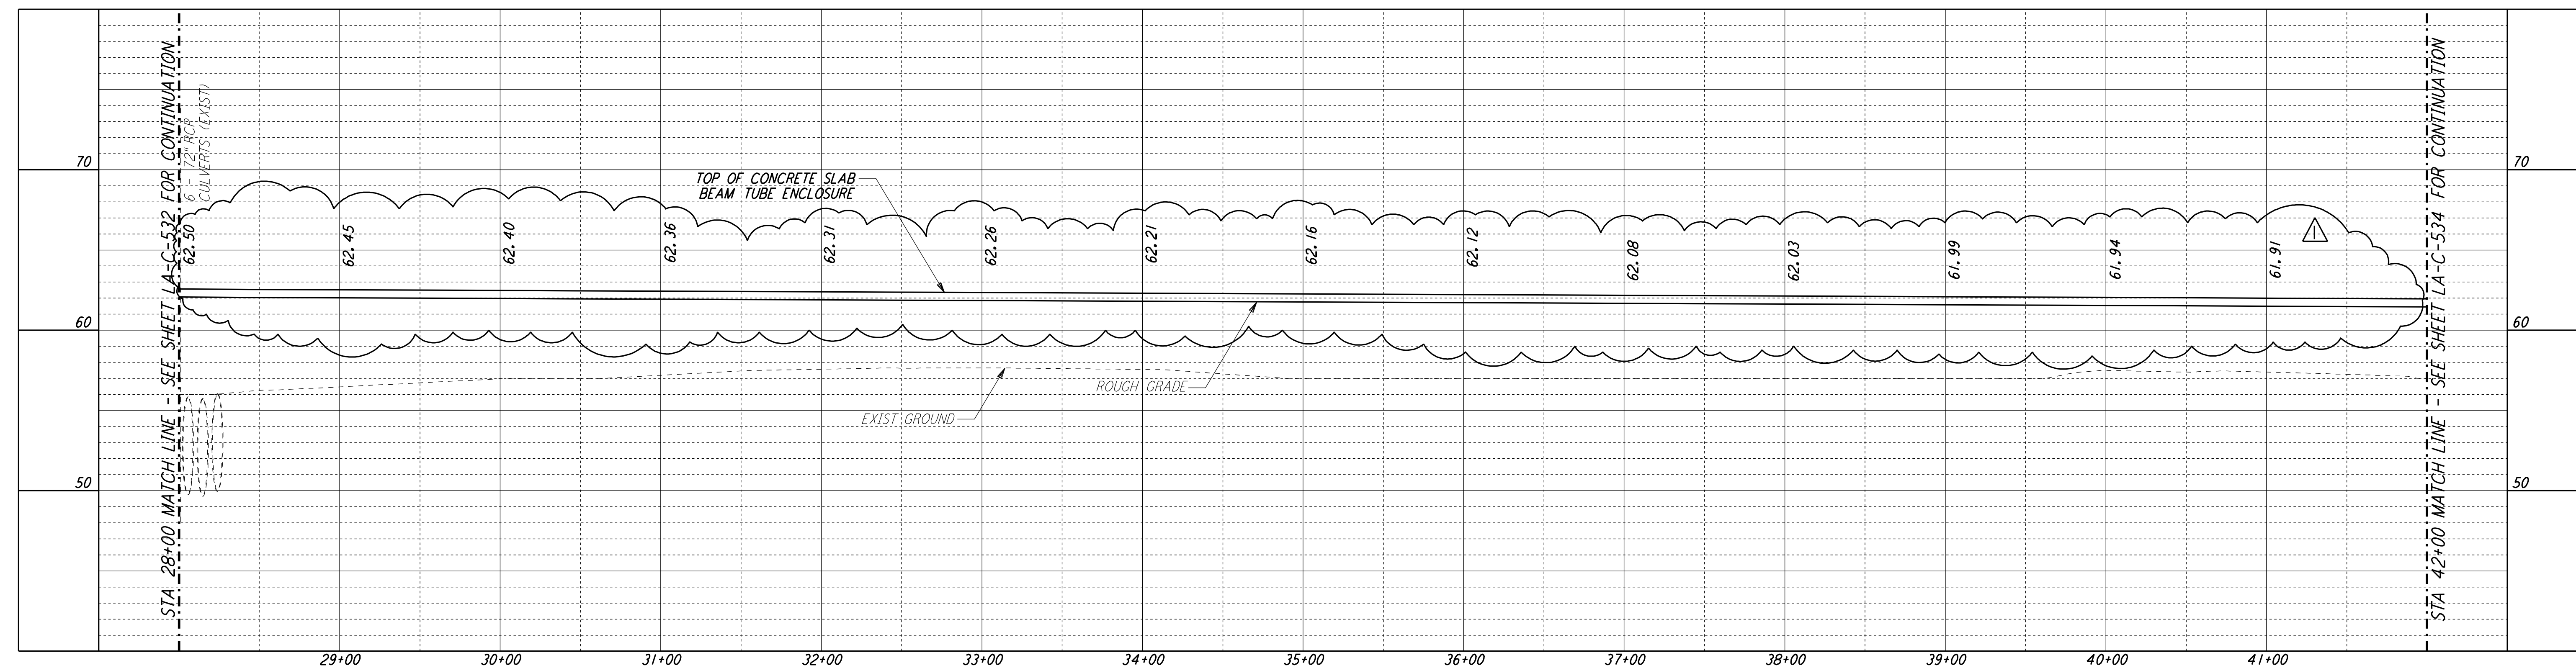

This document and the design it covers are the property of PARSONS. They are loaned only with the borrower's expressed written agreement that they will not be reproduced, copied, loaned, exhibited, or used in any other way, except by written consent from PARSONS to the borrower.

| NO. | DATE | BY | CHKD | ENGR | PROJ | DESCRIPTION |
|-----|--------|-----|------|------|------|----------------------------|
| 1 | 2-3-97 | WRB | | | | REVISED PROFILE ELEVATIONS |

| | | | |
|-------------------------|-----|----------|--|
| ISSUED FOR CONSTRUCTION | | | |
| DRAWN | WRB | 11-15-96 | |
| CHECKED | ML | 11-15-96 | |
| ENGINEER | JB | 11-15-96 | |
| PROJ | TDM | 11-15-96 | |

PARSONS
 100 WEST WALNUT STREET
 PASADENA, CALIFORNIA

LIGO
 CALIFORNIA INSTITUTE OF TECHNOLOGY
 MASSACHUSETTS INSTITUTE OF TECHNOLOGY

LIGO-D961278-01-0

LASER INTERFEROMETER
 GRAVITATIONAL-WAVE OBSERVATORY
 BEAM TUBE ENCLOSURE - LIVINGSTON, LA

| | | | |
|--|-----------|-----------------|----------------|
| TITLE | SCALE | CONTRACT NUMBER | PROJECT NUMBER |
| CIVIL SOUTHEAST ARM PLAN AND PROFILE STA 28+00 TO STA 42+00 | AS NOTED | PP150969 | 8094 |
| SHEET NUMBER | REVISIONS | | |
| LA-C-533 | | | |