
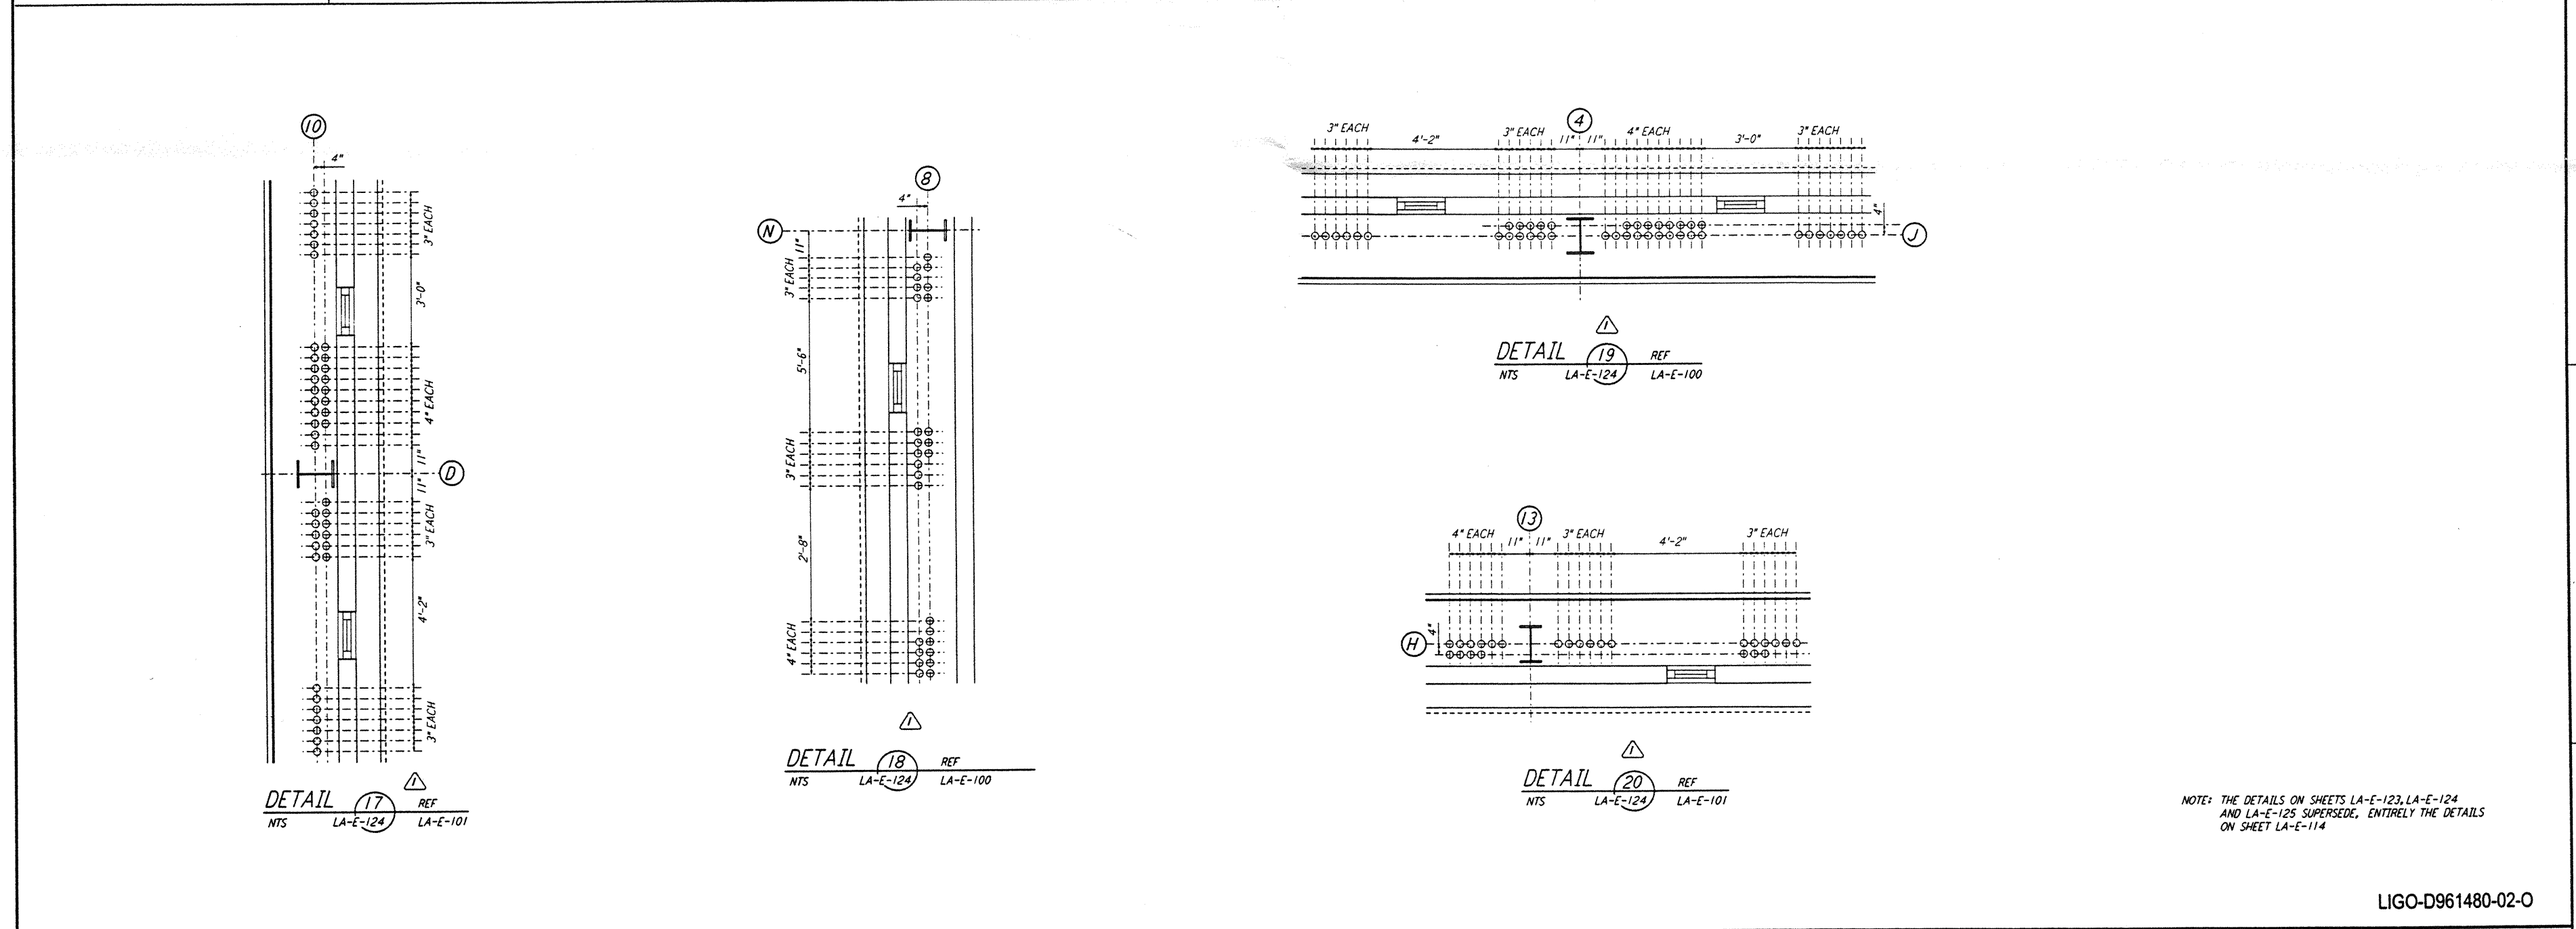



This document and the design it covers are the property of PARSONS. They are loaned only with the borrower's expressed written agreement that they will not be reproduced, copied, loaned, exhibited, or used in any other way, except by written consent from PARSONS.

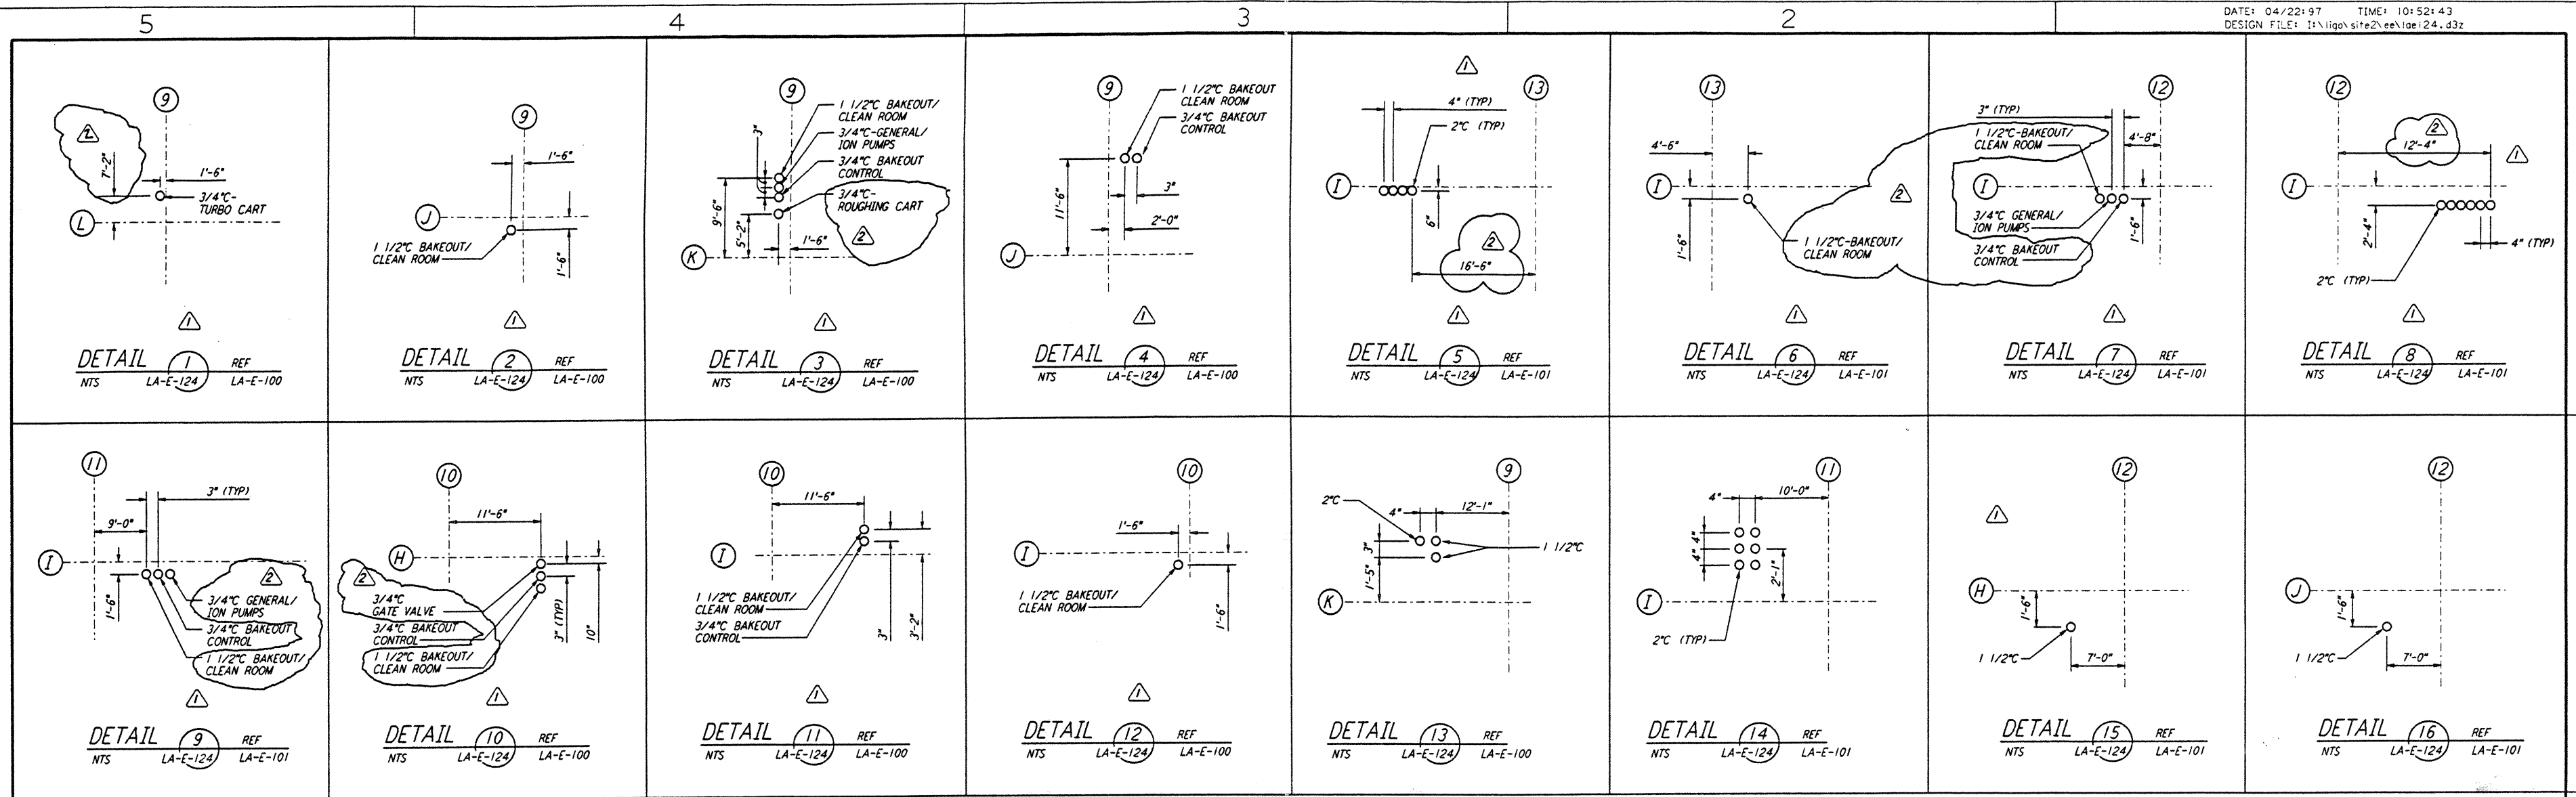

NOTE: THE DETAILS ON SHEETS LA-E-123, LA-E-124 AND LA-E-125 SUPERSEDE, ENTIRELY THE DETAILS ON SHEET LA-E-114

LIGO-D961480-02-0

NO.	DATE	BY	CHKD	ENGR	PROJ	DESCRIPTION
2	4-21-97	J. G.	KR	KR	TDM	REVISED FOR CDS AND VAC. EQUIP.
1	4-4-97	J. G.	KR	KR	TDM	GENERAL REVISIONS

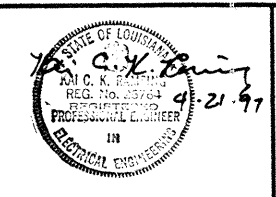

PARSONS
 100 WEST WALNUT STREET
 PASADENA, CALIFORNIA

LIGO
 CALIFORNIA INSTITUTE OF TECHNOLOGY
 MASSACHUSETTS INSTITUTE OF TECHNOLOGY

LASER INTERFEROMETER
 GRAVITATIONAL-WAVE OBSERVATORY
 SITE NO. 2 - LIVINGSTON, LOUISIANA

TITLE: ELECTRICAL CORNER STATION
 LVEA AREAS 101, 102, 103, 104
 DETAILS

SHEET NUMBER: NONE
 PROJECT NUMBER: PP150969
 PROJECT NUMBER: 8094

LA-E-124

LIG04F3.BOR