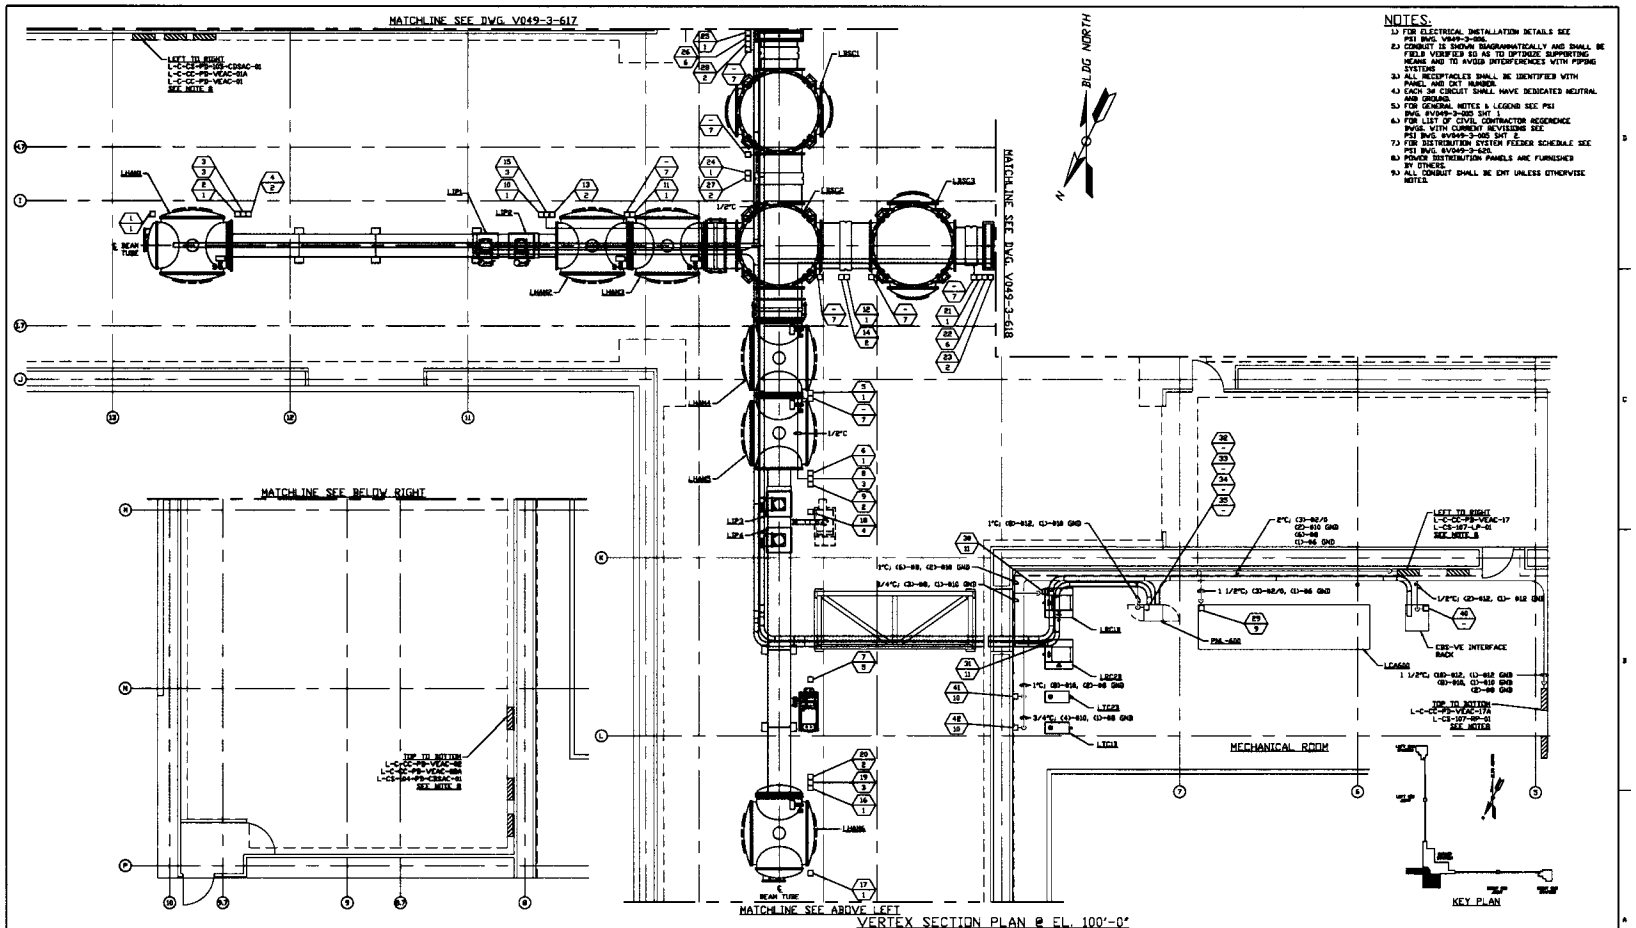

DWG. NO.	DESCRIPTION	DWG. NO.	DESCRIPTION
V049-3-620	DISTRIBUTION SYSTEM FEEDER SCHEDULE LOUISIANA		
V049-3-618	POWER PLAN LOUISIANA RIGHT BEAM MANIFOLD		
V049-3-617	POWER PLAN LOUISIANA LEFT BEAM MANIFOLD		
V049-3-006	ELECTRICAL INSTALLATION DETAILS		
V049-3-005	GENERAL NOTES & LEGEND		
V049-3-003	LOUISIANA OVERALL SITE PLAN	V049-3-620	PNL-600 WIRING DIAGRAM

REFERENCE DRAWINGS

REV	DESCRIPTION	CHKD	DRWN	DATE	DEDN
2	ISSUE FOR AS-BUILT		LD	03.01.99	0644
1	ISSUE FOR CONSTRUCTION	FAB	RJV	04.06.98	0604
0	ISSUE FOR LA DESIGN REVIEW	REB	RMcV	02.24.97	0430

ISSUE DESCRIPTION

PROCESS SYSTEMS INTERNATIONAL INC.
30 WALKUP DR. WESTBOROUGH, MASSACHUSETTS 01581 USA

POWER PLAN
LIGO VACUUM EQUIPMENT
LOUISIANA SITE
VERTEX SECTION

CAD FILE V0493616 | SIZE D | DWG. NO. V049-3-616 | REV 2
SCALE 3/16" = 1' - 0" | SHEET 1 OF 1

EDUCATION VERSION - NOT FOR COMMERCIAL USE